8166

PART NO.	KNOB NO. (COLOR)	WORDING	COLOR	STYLE
8166-	8150-			
-13	8150 -B1 (BLACK)	SWITCH	WHITE	I
-12	81367 (DULL BLACK)	NONE	—	—
-11	8150-B4 (YELLOW)	NONE	—	—
-10	-B3 (TAN)	NONE	—	—
-09	-B1 (BLACK)	WIPER	WHITE	I
~~-08~~	~~-B1 (BLACK)~~	~~PANEL LIGHTS~~	~~WHITE~~	~~II~~ (P)
-07	-B1 (BLACK)	PANEL LAMPS	WHITE	II
-06	-B1 (BLACK)	LIGHTS	WHITE	I
-05	-B1 (BLACK)	HEATER	WHITE	I
-04	-B1 (BLACK)	FAN	WHITE	I
-03	-B1 (BLACK)	DOME LIGHT	WHITE	II
-02	-B2 (IVORY)	NONE	—	—
8166-01	8150-B1 (BLACK)	NONE	—	—

IMPRINTING

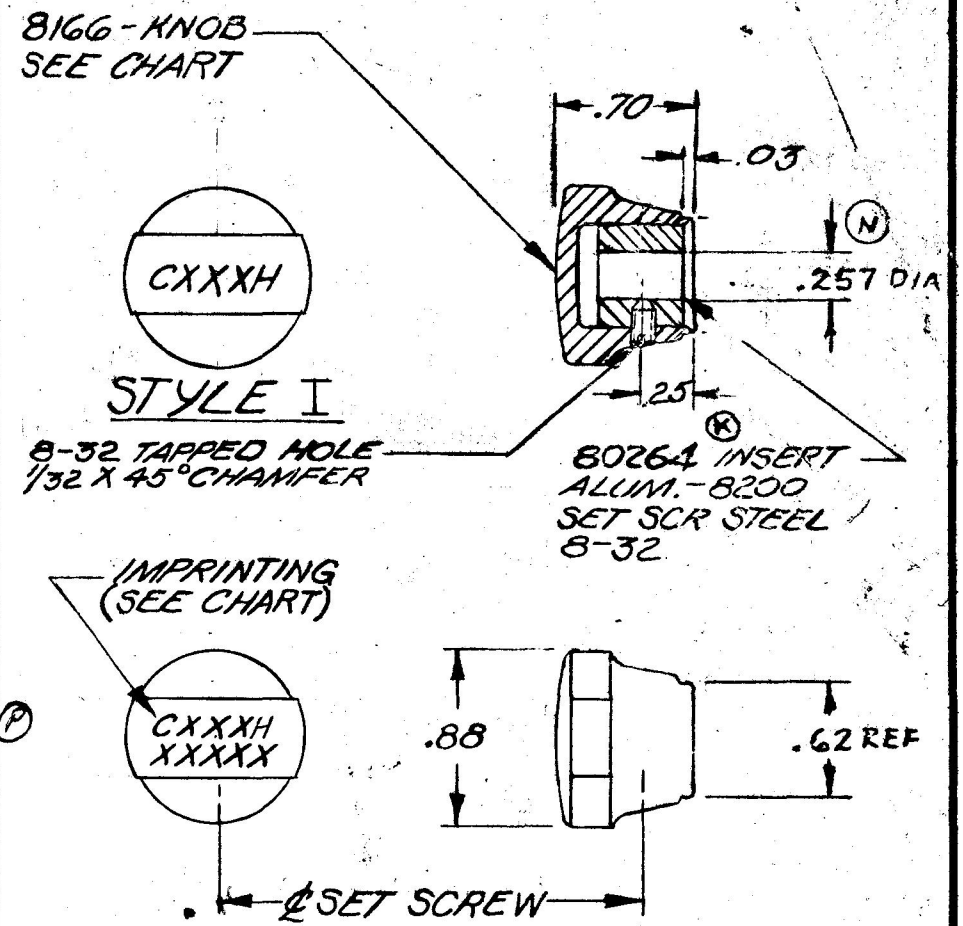

STYLE II (STYLE I EXCEPT IMPRINTING)

STYLE III (STYLE II EXCEPT IMPRINTING)

SEE SEPARATE DRAWING FOR IMPRINTING

DO NOT SCALE

LET	WAS	DATE	BY	LET	WAS	DATE	BY
				N	ADD 18094	4-6-73	RF
				M	COLOR ADDED TO KNOB COL.	3-15-73	R.B.
				L	COLOR ADDED TO KNOB COL.	2-27-73	R.B.
				K	8166-20 17975	1-12-73	CB
P	OBSOLETED 8166-08	3/26/73	[illegible]	J	REV. 17866	9-18-72	JB

MATERIAL	DRAWN	CHECKED	APPRV'D.	SCALE	DATE DRAWN
NOTED	M.W.	REB		2X	9-1-50

FINISH: NOTED

TOLERANCES: FRACTIONAL ± DECIMAL ±.01

COLE-HERSEE COMPANY
BOSTON, MASS. 02127, U.S.A.

KNOB S.A.

DATE BLUEPRINT: 8166

COLE-HERSEE CO.

SPAULDING CO.

Confidential Property of Cole Hersee